
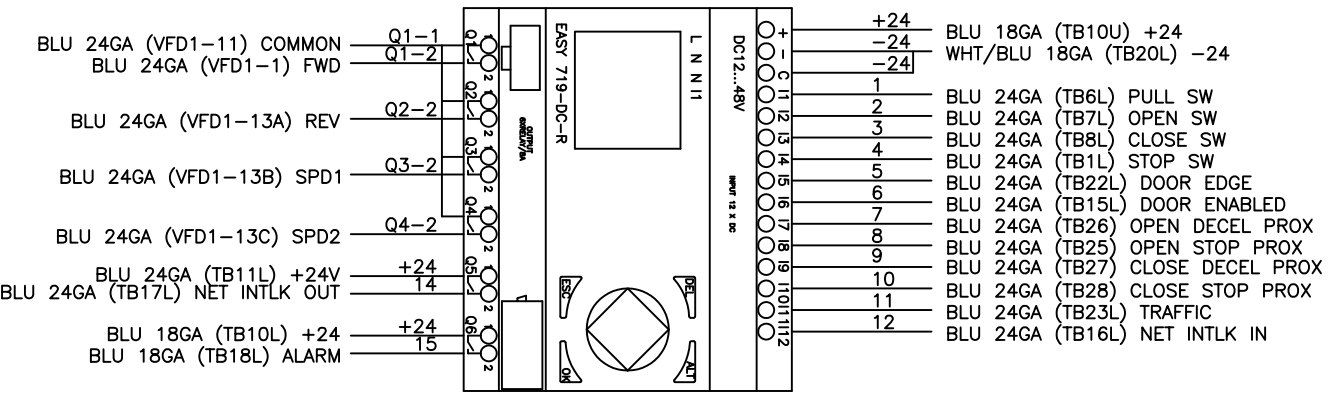
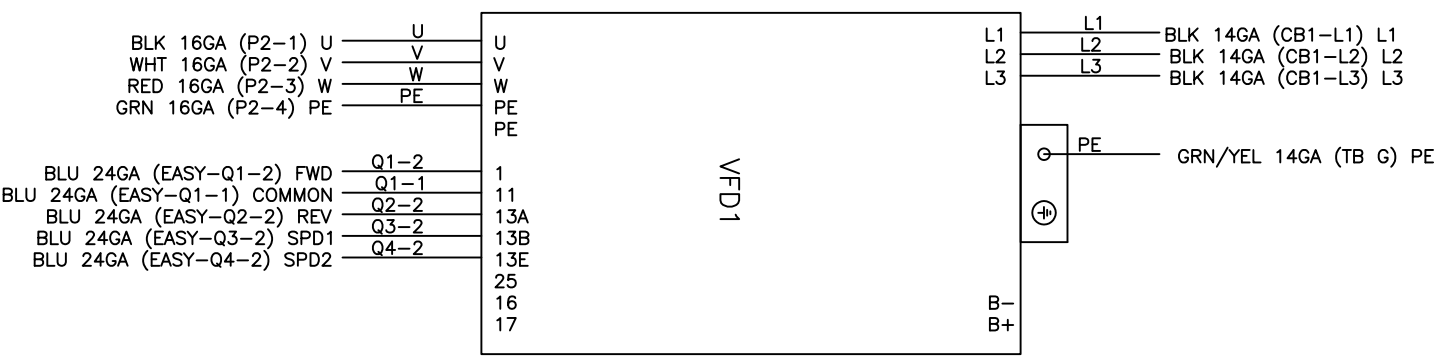
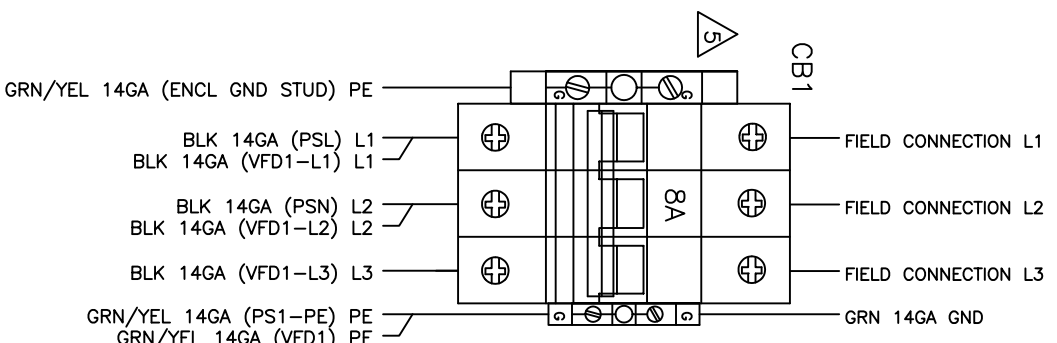
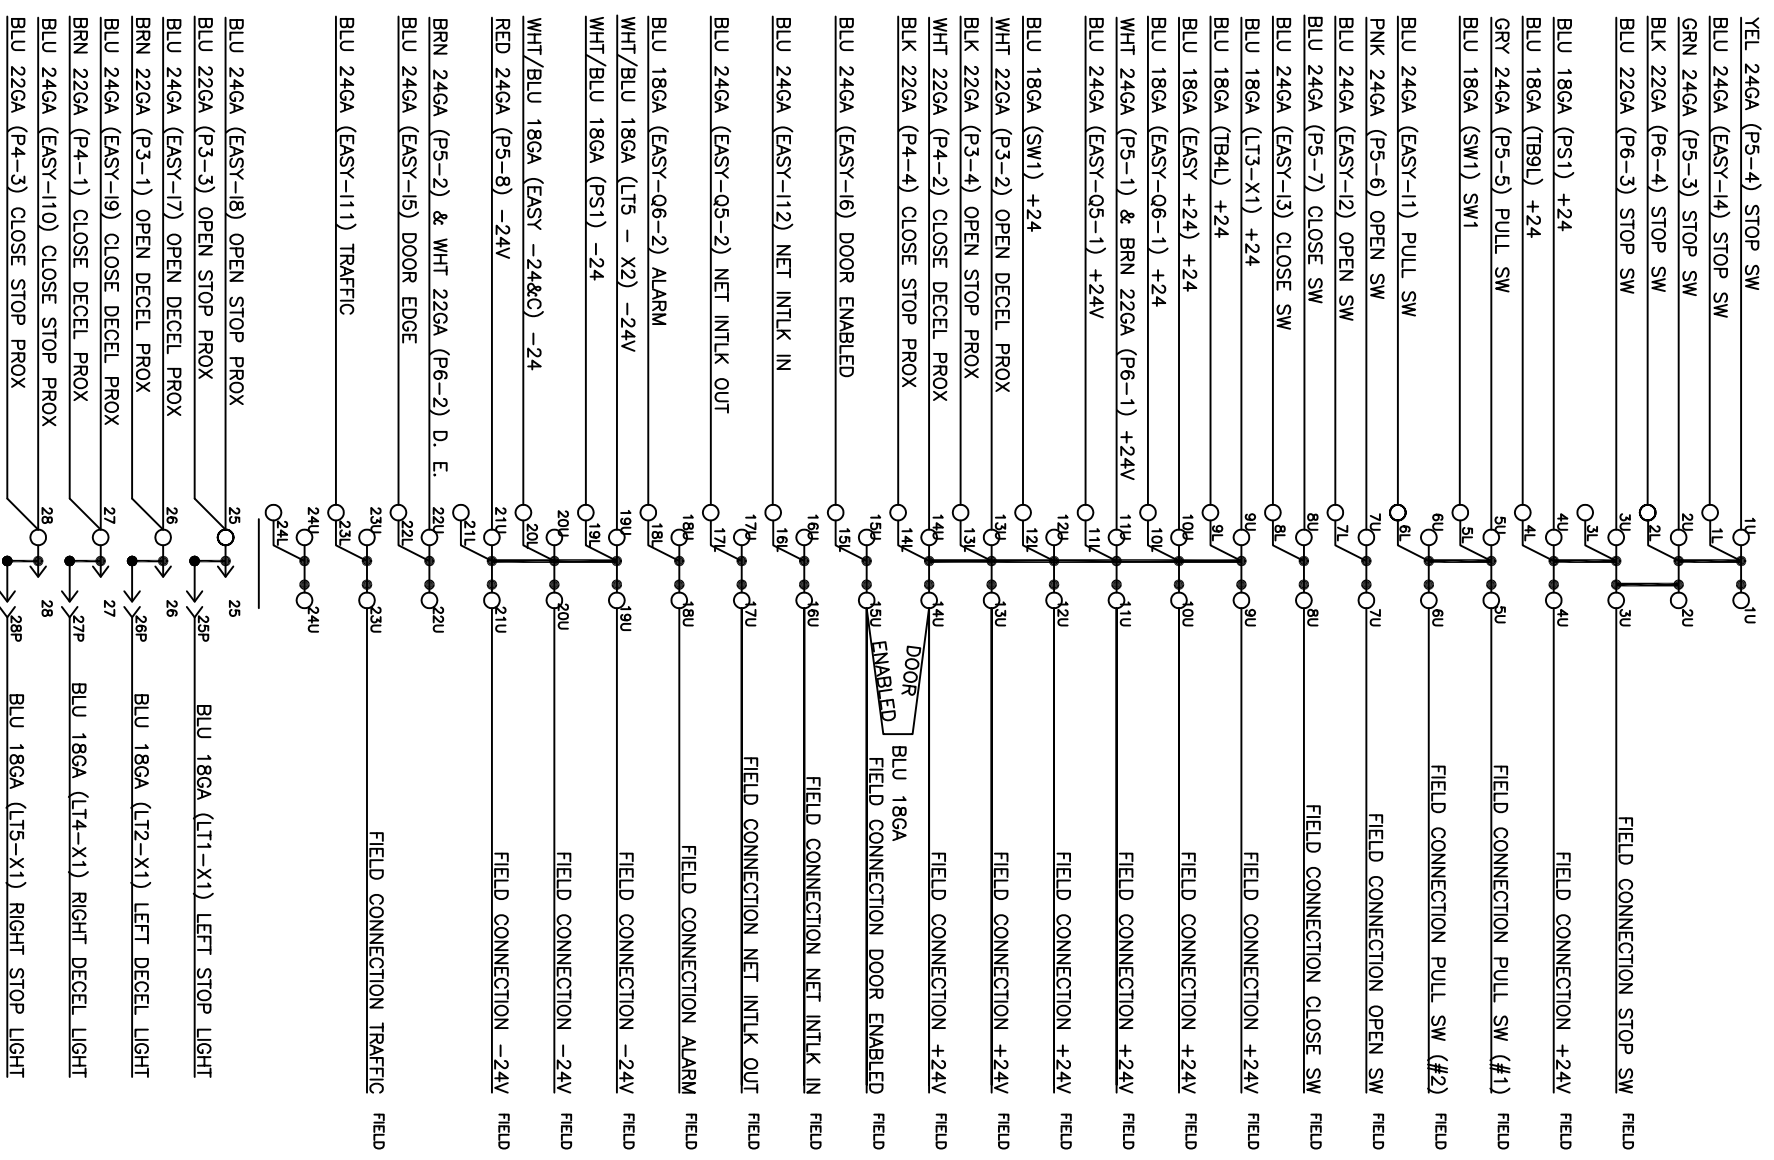


REVISIONS		DATE	APPROVED
ECN No	ZONE I/M	DESCRIPTION	JLD
-	1	INITIAL RELEASE	11/3/08
-	2	AS-BUILT	01.16.08
-	3	REF REV TRIANGLES FOR CHANGES	01.28.08
-	4	REF REV TRIANGLES FOR CHANGES	02.12.09
-	5	REF REV TRIANGLES FOR CHANGES	03.10.09

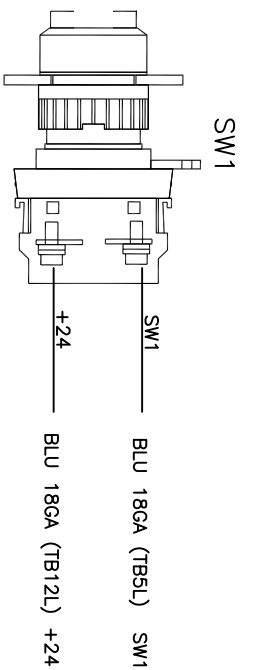

TAB	REV	DESCRIPTION
-01	5	208V OPERATOR
-02	5	460V OPERATOR
-03		
-04		


ITEM NO	PART OR IDENTIFYING NO.	NOMENCLATURE OR DESCRIPTION	MATERIAL	QTY	U/M	EA
01				-00		

DO NOT SCALE DRAWING

SCALE 1/1 FILE: 76001423-XX-5-1 SHEET 1 OF 2


NOTE: TB1-24 ARE PHOENIX P/N 3044513
NOTE: TB25-28 ARE ENTRELEC P/N 011595712 & 011836816

REVISIONS				
ECN No	ZONE I/M	DESCRIPTION	DATE	APPROVED
-	-	5 SEE SHEET 1 FOR DETAILS	03.10.09	S.GWINN

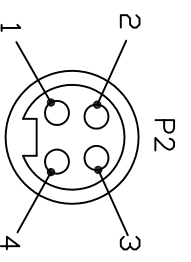


- 1 BLK 16GA (VFD1-U)
- 2 WHT 16GA (VFD1-V)
- 3 RED 16GA (VFD1-W)
- 4 GRN 16GA (VFD1-PE)

RK46-1M

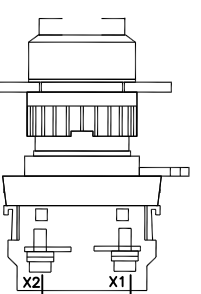


- LT1 BLU 18GA (TB25P) LEFT STOP SENSOR
- 24 WHT/BLU 18GA (LT2) -24

LEFT STOP SENSOR

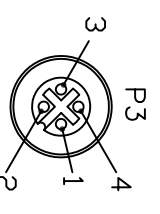


- 1 BRN 22GA (TB26)
- 2 WHT 22GA (TB13U)
- 3 BLU 22GA (TB25)
- 4 BLK 22GA (TB13L)

FK4.4-1

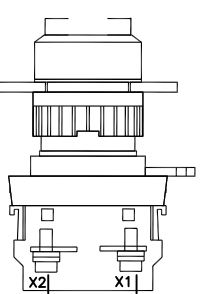


- LT2 BLU 18GA (TB26P) LEFT DECEL SENSOR
- 24 WHT/BLU 18GA (LT1-X2) -24
- 24 WHT/BLU 18GA (LT3-X2) -24

LEFT DECEL SENSOR

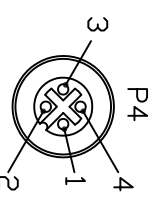


- 1 BRN 22GA (TB27)
- 2 WHT 22GA (TB14U)
- 3 BLU 22GA (TB28)
- 4 BLK 22GA (TB14L)

FK4.4-1

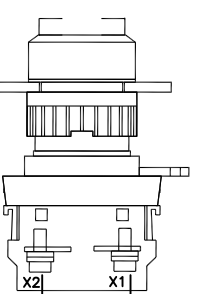


- LT3 BLU 18GA (TB9U) POWER ON
- 24 WHT/BLU 18GA (LT2-X2) -24
- 24 WHT/BLU 18GA (LT4-X2) -24

POWER ON

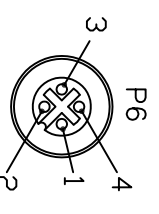


- 1 BRN 22GA (TB11U)
- 2 WHT 22GA (TB22U)
- 3 BLU 22GA (TB3U)
- 4 BLK 22GA (TB2L)

FK4.4-1

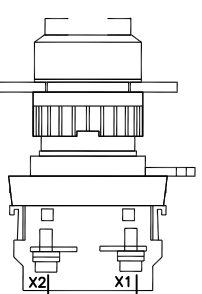


- LT4 BLU 18GA (TB27P) RIGHT DECEL SENSOR
- 24 WHT/BLU 18GA (LT3-X2) -24
- 24 WHT/BLU 18GA (LT5-X2) -24

RIGHT DECEL SENSOR

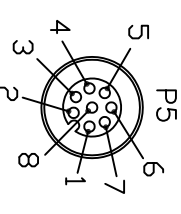

- 1 WHT 24GA (TB11U)
- 2 BRN 24GA (TB22U)
- 3 GRN 24GA (TB2U)
- 4 YEL 24GA (TB1U)
- 5 GRY 24GA (TB5U)
- 6 PNK 24GA (TB7U)
- 7 BLU 24GA (TB8U)
- 8 RED 24GA (TB21U)

FK8-1

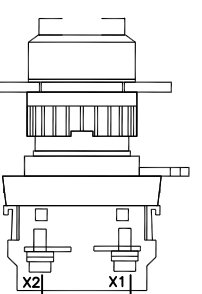

- LT5 BLU 18GA (TB28P) RIGHT STOP SENSOR
- 24 WHT/BLU 18GA (LT4-X2) -24
- 24 WHT/BLU 18GA (TB19U) -24

RIGHT STOP SENSOR

CCNW		SIZE	DWG NO.	REV
APPROVALS	DATE	D	76001423-XX	5
DRAWN JLD	11/3/08	SCALE 1:1	FILE: 76001423-XX_5_2	SHEET 2 OF 2
CHECKED				